

CONTRACT : TNB 35/2011



**TENAGA
NASIONAL** BERHAD

Superseded

**SUPPLY, ERECT AND COMMISSIONING SELECTED 275KV & 132KV RELAY REPLACEMENT
PHASE 2 FOR ASSET MAINTENANCE MAINHEAD B**

SUBSTATION :

PMU YONG PENG EAST 275KV (BAY KAWA 2)

AS-BUILT SCHEMATIC DRAWING

CONTRACTOR:

RELTECH VENTURES SDN BHD,

*formerly known as W.E Engineering (M) Sdn Bhd
(company No.374767-P)*

**NO 14E TINGKAT 5,
WORLDWIDE BUSINESS PARK,
BLOK 2 JALAN TINJU 13/50,
SEKSYEN 13 SHAH ALAM
SELANGOR**

TEL NO : 03-5511 9895 FAX : 03-5511 9885

Superseded

☐ For
PRELIMINARY REVIEW

☐ For
TNB APPROVAL

☐ Revised
"AS-MANUFACTURED"

☒ Updated
"AS-BUILT"

REMARKS:

Revision	Description	Date	Approved
2	AS-BUILT	17.10.12	
1	AS-BUILT	17.05.12	

DRAWN BY:	MAZWAN MUSTAFFA	DATE:	27.07.11
DESIGNED BY:	NIK LUQMAN HAKIM NIK MOHAMED	DATE:	27.07.11
CHECKED BY:	NORAZLAN HJ. ZAM ZAM	DATE:	27.07.11
REVIEWED BY:			

OWNER/CLIENT:



**TENAGA
NASIONAL BERHAD**

CONTRACTOR:



RELTECH VENTURES SDN BHD
NO. 14E, 5th FLOOR, WORLDWIDE BUSINESS PARK,
BLOK 2, JALAN TINJU 13/50, SEKSYEN 13,
40100 SHAH ALAM
SELANGOR DARUL EHSAN
TEL : 03-55119895 FAX : 03-55119885

SUPPLIER/MANUFACTURER:



SNR TECHNOLOGY SDN. BHD.
NO. 7, JALAN 9/6
TAYAN IKS, SEKSYEN 9
43650 BANDAR BARU BANGI, SELANGOR DARUL EHSAN
TEL: 603-89269919 FAX: 603-89222185 EMAIL: info@snrtech.my

PROJECT TITLE:

SUPPLY, ERECT & COMMISSIONING OF
SELECTED 275kV & 132kV
RELAY REPLACEMENT PHASE 2
FOR ASSET MAINTENANCE - MAINHEAD B

CONTRACT No: TNB 35/2011
TENDER No: TNBT 808810

SUBSTATION:

PMU YONG PENG EAST 275kV S/S

DRAWING TITLE:

275kV PROTECTION
OHL FEEDER - KG. AWAH NO.2
SCHEMATIC DIAGRAM

DRAWING NO.:

RVSB YPGE PJ26 275 S09 KA2

REV.
2

THIS SHEET: 01
NEXT SHEET: 02

1	2	3	4	5	6	7	8	
A						REMARKS:		
B								
C						AS-BUILT		
						13.12.2021		
						TENG		
D						Revision		
						Description		
						Date		
						Reviewed		
E						DRAWN BY: SITI MARIAM		
						DATE: 03.03.2020		
						DESIGNED BY: SUFYAN		
						DATE: 03.03.2020		
						CHECKED BY: SUFYAN		
						DATE: 03.03.2020		
						REVIEWED BY: TENG		
						DATE: 03.03.2020		
F						OWNER/CLIENT:		
								
						CONTRACTOR:		
								
						JOINT VENTURE		
						PROJECT TITLE:		
						KERJA-KERJA REPLACEMENT OF SUBSTATION CONTROL SYSTEM FOR GRID MAINTENANCE, GRID DIVISION, TNB UNTUK MAINHEAD C: PMU YONG PENG EAST 500/275kV		
						CONTRACT NO.: TNB 3923/2019 TENDER NO.: RFx 4000028451		
						SUBSTATION:		
						PMU YONG PENG EAST 500/275kV		
					DRAWING TITLE:			
					275kV PROTECTION & CONTROL DIAMETER D04-OHL FEEDER: BAHAU SOUTH NO.2 SCHEMATIC DRAWING			
					= D04			
					+ / A1			
					DRAWING NO. :			
					BESB MHC TNB3923/2019 275 S 04			
					REV. :			
					AS-BUILT			
					THIS SHEET : 01			
					NEXT SHEET: 02			

☐ For PRELIMINARY REVIEW

☐ For CLIENT APPROVAL

☐ Issue For CONSTRUCTION

☐ Revised "AS-MANUFACTURED" (After 'FAT')

☒ Updated "AS-BUILT" (After 'SAT')

[illegible]

Drawn by	Order No. L.	Sheet
ID	TID-No.	
Design checked by	Rev In	Year Week Cont


Drawn by	Form No.	Sheet
Design checked by	Rev In Dept	Year Week Cont

This document must not be copied without our written permission, and the contents thereof must not be imparted to a third party nor be used for any unauthorized purpose.

[illegible]

		SCHEMATIC DIAGRAM		Design checked by A.G. MENON		145927			Rev In Sheet		
		275kV BAHAU SOUTH NO.2		Design by MORTAZA		XMA 301 95K-AC			Rev In Sheet		
Rev In Revision		LIST OF CONTENTS		Drawn by BRITTO		ABB T & D SDN BHD			NO. 4/PP/500kV/YGPG/600S YONG PENG 275kV S/S		
Anad Year Week						Dept Year Week NE-DIV 97 13				Cont 051	

Superseded

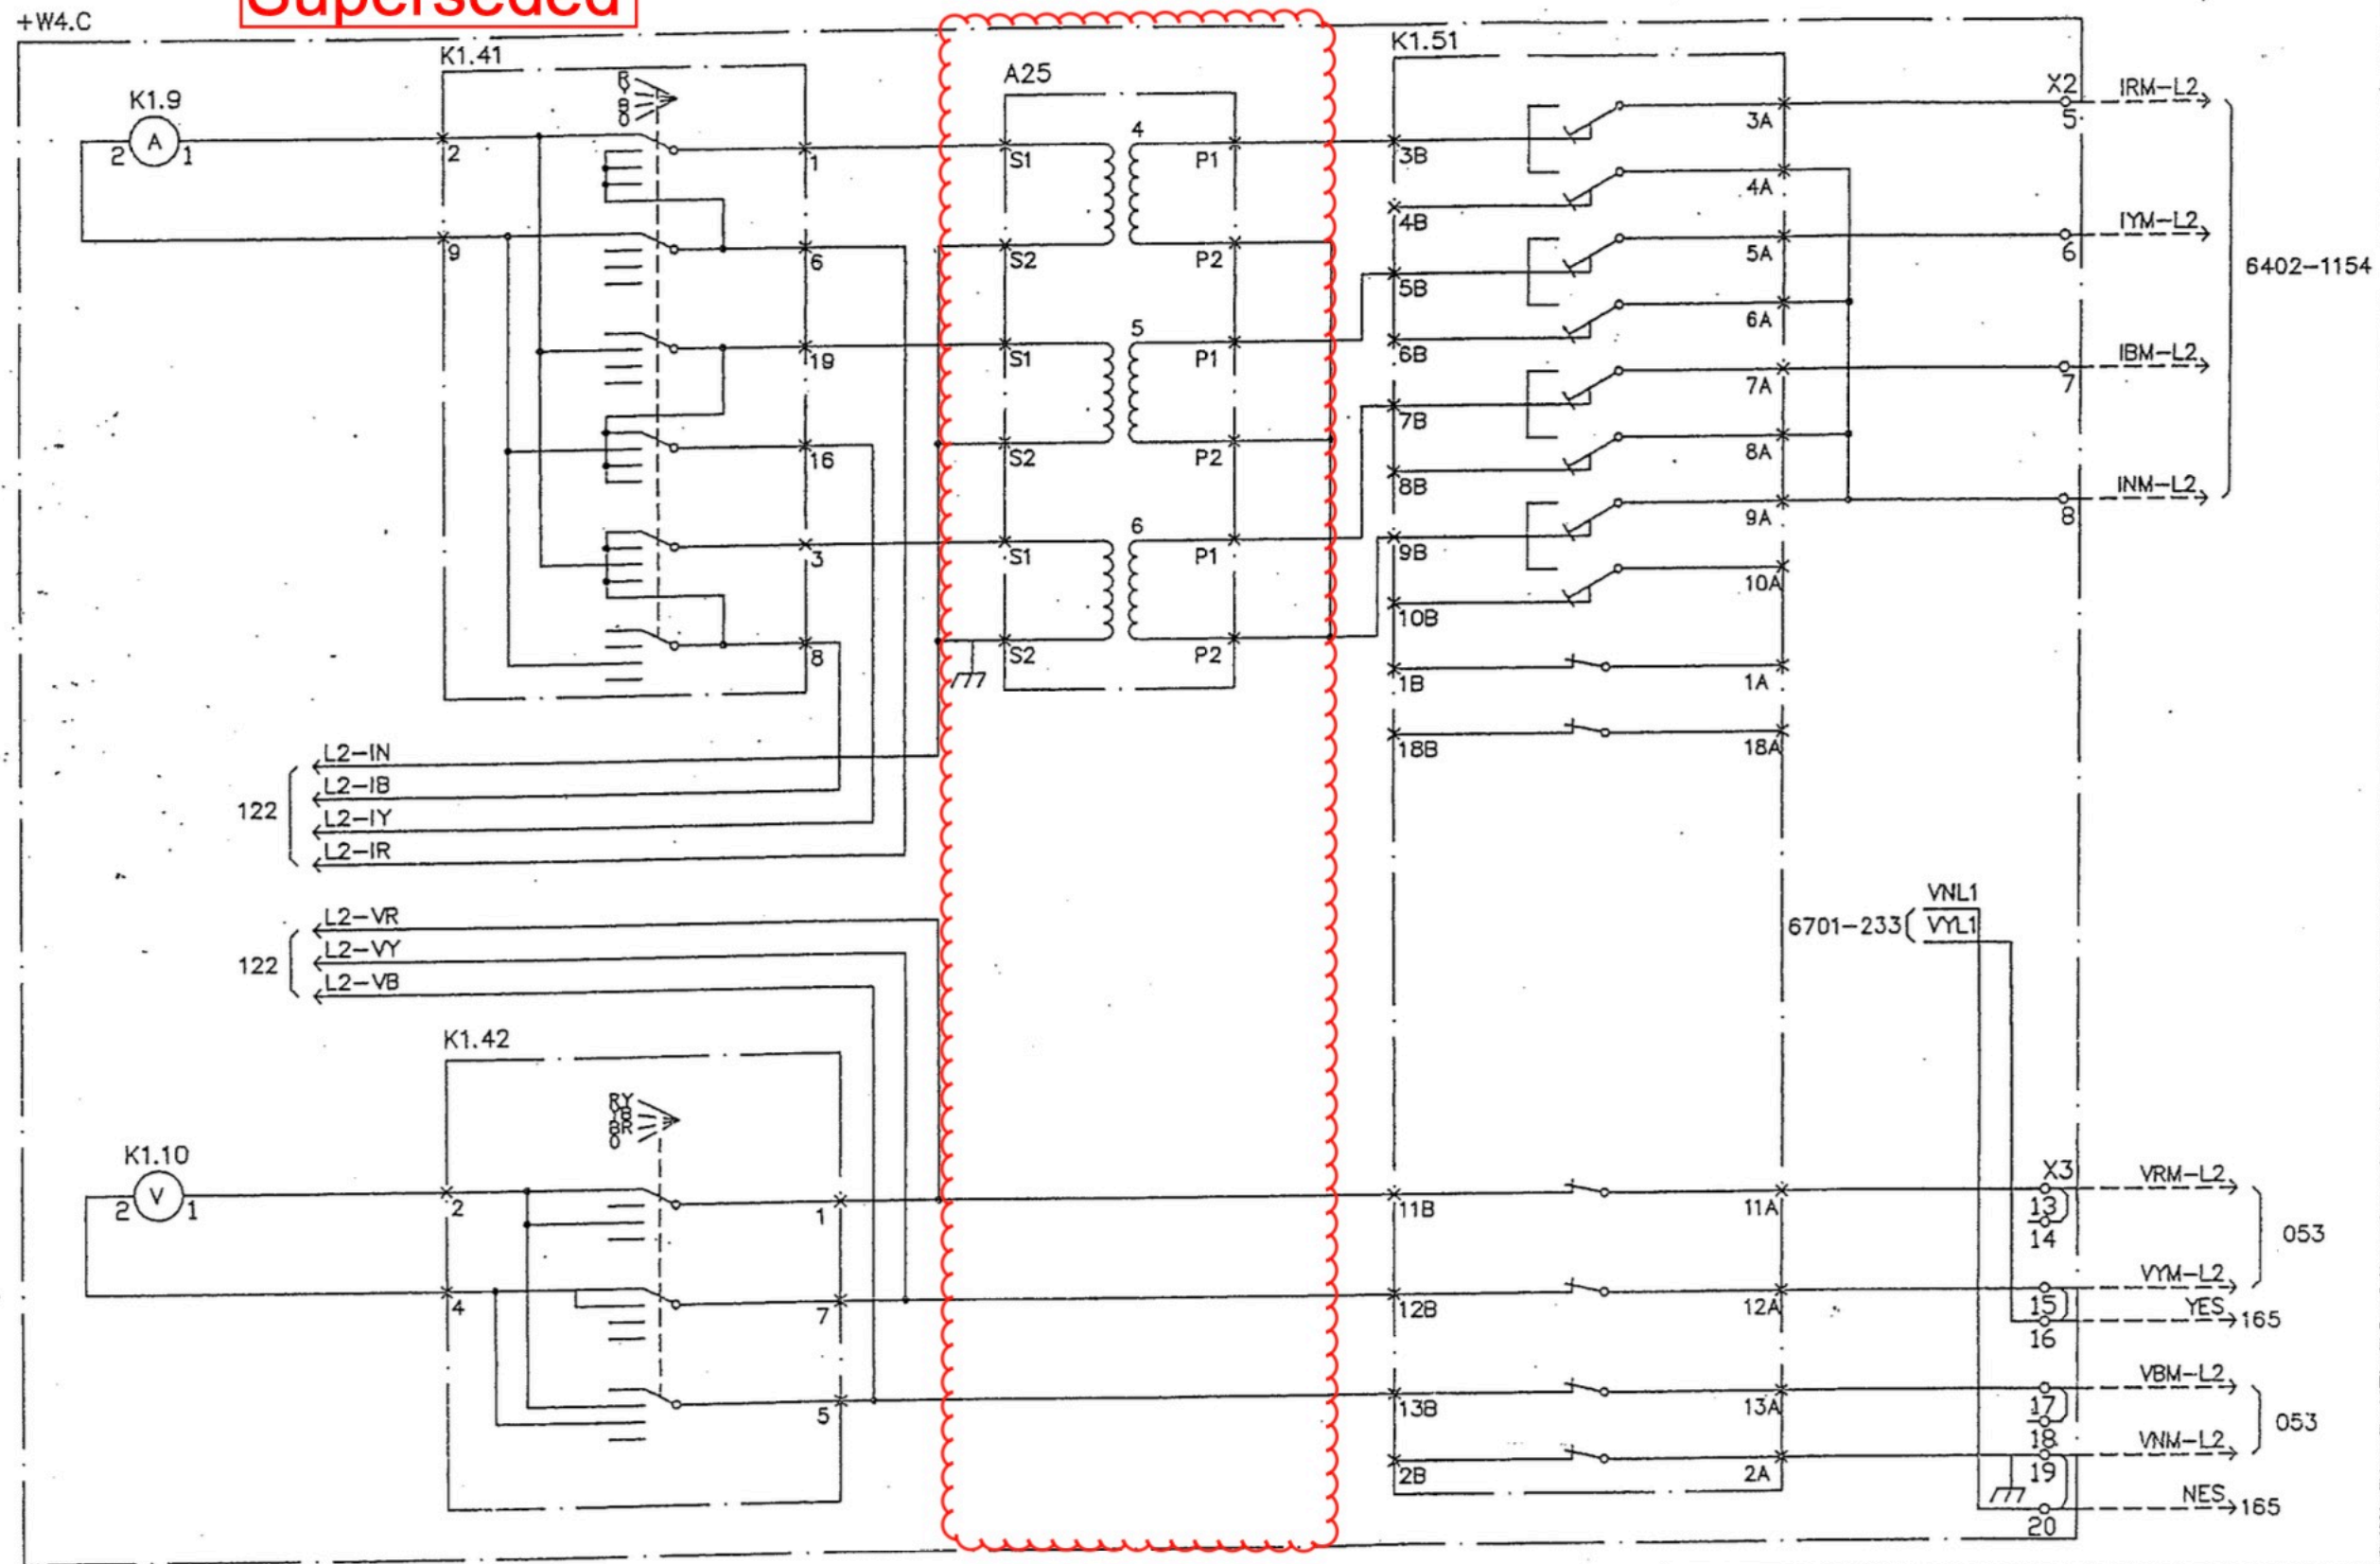

SCHEMATIC DIAGRAM

275kV KAMPONG AWAH -2 LINE
METERING

Design checked by
A.G. MENON

Design by
MORTAZA

Drawn by
BRITTO

145927

XMA 301 95K-AC

ABB T & D SDN BHD

D	Dept	Year	Wes
	NE-DIV	97	12



NO. 4/PP/500kV/YGPG 6008
YONG PENG 275kV S/S

Rev In Sheet

Rev In Sheet

121

Cont
123

2018

21

CONTRACT : TNB 35/2011



**TENAGA
NASIONAL** BERHAD

Superseded

**SUPPLY, ERECT AND COMMISSIONING SELECTED 275KV & 132KV RELAY REPLACEMENT
PHASE 2 FOR ASSET MAINTENANCE MAINHEAD B**

SUBSTATION :

PMU YONG PENG EAST 275KV (BAY KAWA 2)

AS-BUILT SCHEMATIC DRAWING

CONTRACTOR:

RELTECH VENTURES SDN BHD,

*formerly known as W.E Engineering (M) Sdn Bhd
(company No.374767-P)*

**NO 14E TINGKAT 5,
WORLDWIDE BUSINESS PARK,
BLOK 2 JALAN TINJU 13/50,
SEKSYEN 13 SHAH ALAM
SELANGOR**

TEL NO : 03-5511 9895 FAX : 03-5511 9885