


Superseded

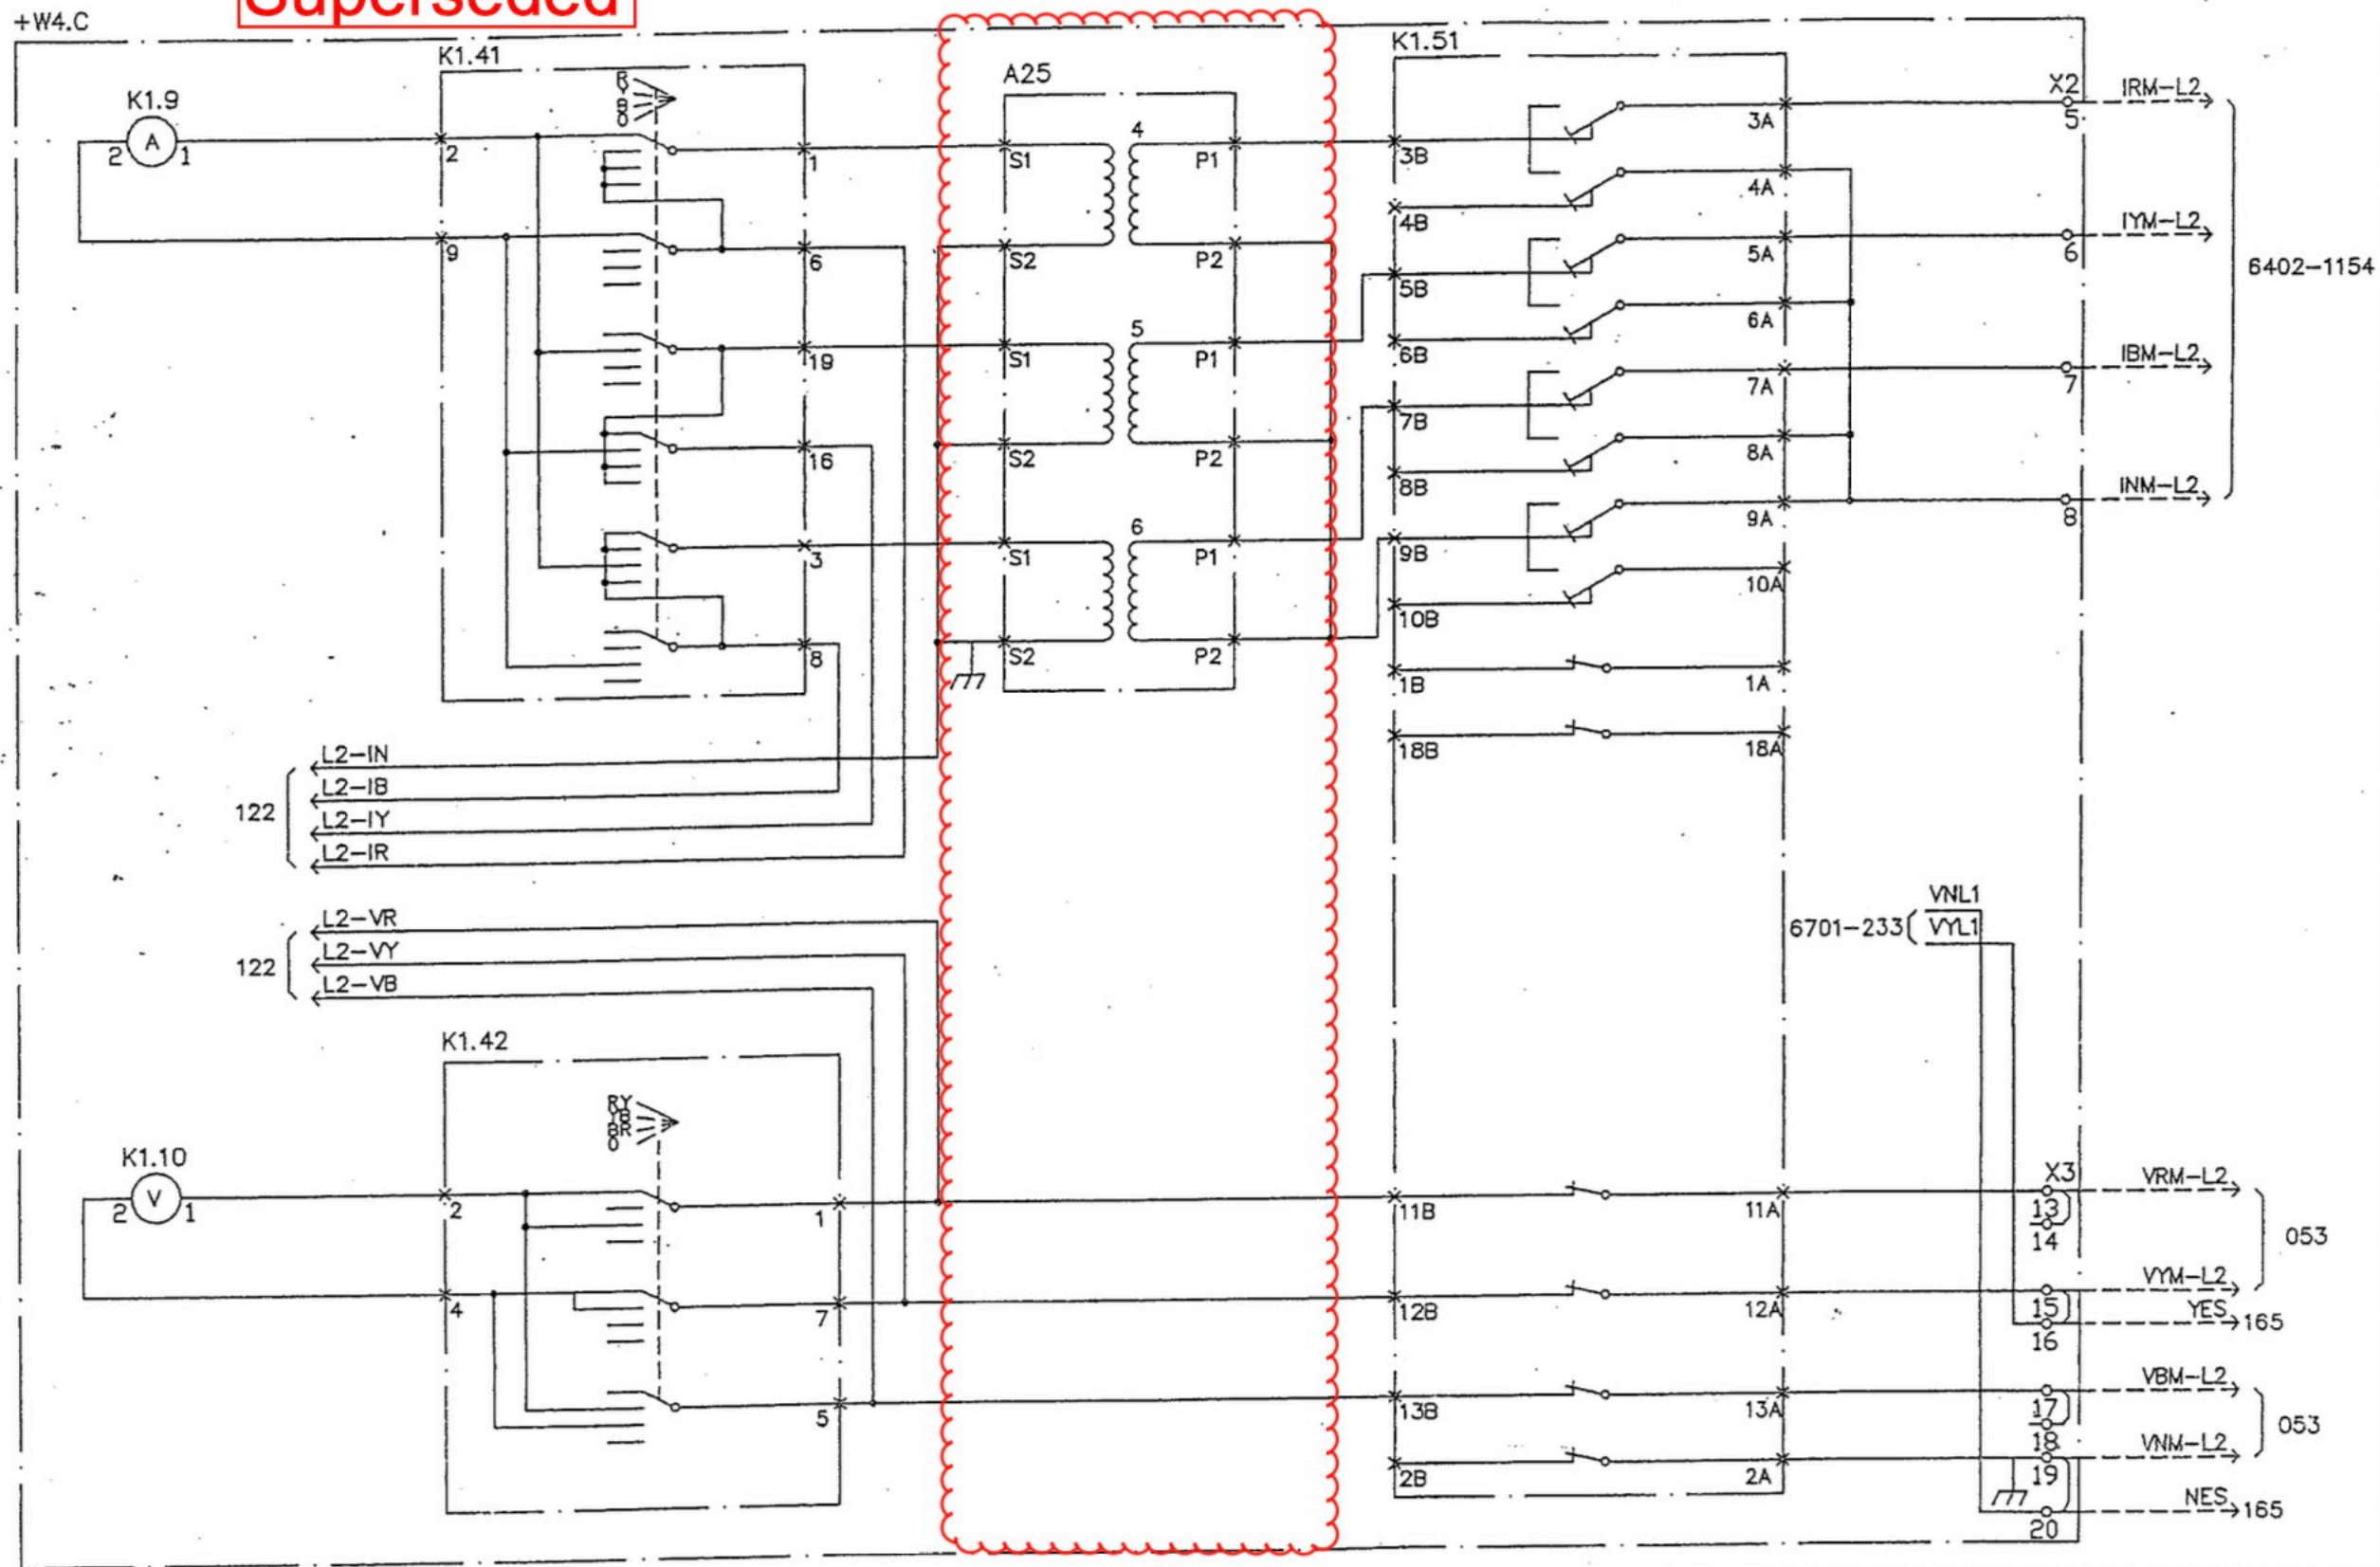

SCHEMATIC DIAGRAM

275kV KAMPONG AWAH -2 LINE
METERING

Design checked by
A.G. MENON
Design by
MORTAZA
Drawn by
BRITTO

145927
XMA 301 95K-AC

ABB T & D SDN BHD Dept Year Week
NE-DIV 97 12



NO. 4/PP/500kV/YGPG 6008
YONG PENG 275kV S/S

Rev In Sheet
Rev In Sheet
Cont
121
123

ABB

CONTRACT : TNB 35/2011



**TENAGA
NASIONAL** BERHAD

Superseded

**SUPPLY, ERECT AND COMMISSIONING SELECTED 275KV & 132KV RELAY REPLACEMENT
PHASE 2 FOR ASSET MAINTENANCE MAINHEAD B**

SUBSTATION :

PMU YONG PENG EAST 275KV (BAY KAWA 2)

AS-BUILT SCHEMATIC DRAWING

CONTRACTOR:

RELTECH VENTURES SDN BHD,

*formerly known as W.E Engineering (M) Sdn Bhd
(company No.374767-P)*

**NO 14E TINGKAT 5,
WORLDWIDE BUSINESS PARK,
BLOK 2 JALAN TINJU 13/50,
SEKSYEN 13 SHAH ALAM
SELANGOR**

TEL NO : 03-5511 9895 FAX : 03-5511 9885